

# CITY OF WOODBURN COMMUNITY DEVELOPMENT

### **MEMORANDUM**

270 Montgomery Street

Woodburn, Oregon 97071

Phone (503) 982-5246

Fax (503) 982-5244

**Date:** March 10, 2022

**To:** Dago Garcia, P.E., City Engineer

**Cc:** Chris Kerr, AICP, Community Development Director

Jamie Van Agtmael, PLS, President

From: Colin Cortes, AICP, CNU-A, Senior Planner

Subject: Planning Division review comments on original submittal Feb. 8 of civil

engineering plans for Allison Way Apts. Ph. 2

## **Summary**

Planning Division staff identifies revisions needed before sign-off on Public Works Department Engineering Division approval and issuance of civil engineering plans for Allison Way Apartments Phase 2 (DR 2019-05) along the east/southeast side of Allison Way south of Hooper Street.

The City Engineer hosted virtual meetings with Planning Division staff March 2 & 10 regarding the original submittal of February 8.

#### **Revision Items**

The applicant needs to address the items below.

A. Condition G5: Did the developer record lot consolidation PLA 2019-04? If so, submit a paper and Adobe PDF copy of the recorded document and update the parcel label on Sheet EX-1 / 3.

Condition PLA-1 requires that the developer record the lot consolidation before requesting address assignment, which in turn is necessary before building permit application.

B. Condition G6: Not met. Meet.

"G6. Public Improvements Civil Plan Review: The process by which to receive, review, and approve drawings and other documents related to public improvements required by these conditions of approval may be paired with or incorporated into building permit review, or, if directed by the City Engineer, through a civil engineering plans (CEP) review process led by the Engineering Division. If opting for CEP, the applicant shall not only follow the direction of the Engineer Division, but also take some actions to facilitate tracking by Planning staff and coordination with Engineering:

- a. Cover letter: Upon submitting application to the Engineering Division, simultaneously alert the Planning Division through a cover letter to the attention of the Planning Division referencing the intended or, if known, actual submittal date as well as the project name, project phase, tax lot number(s), street address(es), and the land use / planning / zoning final decision conditions of approval that require the public improvement that is the subject of the civil engineering plans. Referencing conditions may be by quotation or citing the identification numbers (e.g., T-A1). Identify the specific sheet (by number) or document page number that illustrates or notes how each subpart of a condition is met.
- b. Contact information: State the applicant's name, company, phone number, e-mail, and desired date for City staff to respond with review comments. The cover letter may include these.
- c. Plan copies: Submit to the attention of the Planning Division at least two plan size copies of plan sets (24 by 36 inches). Within the cover sheet title block(s), include the phrase "civil engineering plans" or "public improvements civil plans". Submit also Adobe PDFs using a fileshare service.
- d. Re-submittal fee: If there are multiple re-submittals, beginning with a third submittal / second revised submittal and continuing with each subsequent submittal, the applicant shall pay through the Planning Division into City general revenue a fee of \$100."
- C. Condition D1: Demonstrate conformance.
- D. Condition D2c(1)(a): Correct to add an arrow at each of three aisle ends that are missing them. Revise Sheets SP-1 / 25 & SP-2 / 26.
- E. No outlet: Revise Sheet SP-2 / 26 to add a W14-2 no outlet sign at the drive aisle south of Building P.

- F. Scope: Does the developer expect review of each of the following during CEP or building permit review?
  - 1. Conditions D6 & V-6-3-2a & b;
  - 2. Condition D7;
  - 3. Condition V4-6b, c, & d; and
  - 4. Condition V6-3-2d(1) & (3); e; and g(1).
- G. Condition EX2b: Relating to the Stacy Allison Way extension, demonstrate conformance regarding:
  - Part (4): Tree, shrubbery, and lawn grass details. Submit a landscaping plan sheet series.
  - Part (8): NW side landscaping. Submit a landscaping plan sheet series.
  - Part (9): Interim signage. Revise Sheet SP-2.

Neither the private improvements nor public improvements plan set shows enough street landscaping information.

Sheet GN-1 / 2 has a Phase 2 street cross section, but to determine conformance with Parts (4) & (8) necessitates also plan view of landscaping and of more than just the street trees.

The public improvements plan set cover sheet (CV-1) has a landscape sheet index, but none of these sheets are in the set.

H. Off-site improvements tied to Phase 2: Demonstrate conformance.

T-BP3: Clarify what, if any, trees are being moved. For example, on Sheet PR T-BP3 / 14, the second tree from the south appears all but necessarily eliminated by the sidewalk alignment, but there's no call-out indicating either removal or preservation. The situation is less acute but similar for the next two trees northward. Even having looked at Sheet EX T-BP3 / 13 ("demolition"), its Note PT makes sense, but doesn't appear believable based on Sheet 14. Please clarify the sheets, and include basic info about the existing three south trees: species and either caliper or diameter at breast height (DBH).

T-BP4: No comment other than to confirm that the plan set excludes it because the developer proposed to improve this earlier along with Condition T-BP2 (Evergreen sidewalk west) as part of Phase 1 civil engineering plans.

T-BP5: There is no crosswalk striping. Confirm if the City Engineer directed that the crossing not be striped as a crosswalk.

T-BP6: No comment.

T-BP7: No comment.

I. Condition V3-5a: Illustrate and note the speed table missing from the walkway crossing Allison Way Apts. Ph. 2 civil engineering plans (original/1st submittal Feb. 8, 2022) 3/10/2022 3

nearest and between the clubhouse, play area, and Building R. The condition refers to specs in Condition G3:

"Speed table' means a walkway crossing of a drive aisle that: is concrete; with a tabletop that is raised at least four (4) inches above drive aisle grade, at least six (6) ft wide, flat, and stamped or otherwise treated to have a pattern; and, with the vehicular ramps striped in compliance with MUTCD Figure 3B-30, Option A, and with minimum and maximum slope ratios of 1:25 and 1:10 respectively."

Revise Sheet GR-8 / 18, add a detail to a details sheet, and add a Sheet GR-8 / 18 reference to the detail.

- J. Condition V6-3-2c(2). The access way 8-ft width extends south to near the BBQ area. Extend to the clubhouse southwest doors / play area by widening the three narrow walkway segments. Revise Sheets GR-7 / 17 & GR-8 / 18.
- K. Condition V9-2: Indicate number of apartments, the conditioned parking ratio of 1.9 stalls per dwelling, minimum number of stalls required, and proposed number of stalls. Revise at least Sheets UT-1 / 4 & SP-1 / 25.

#### **Next Steps**

Planning Division requests revisions and re-submittal by the applicant and affirms that the Public Works Department Engineering Division is not to approve civil engineering plan until Planning outstanding items are resolved.


The developer will include a dated cover letter to my attention referencing the civil engineering plans file number (if any), re-submittal date, project name, and phase, citing each revision item by letter/number, and for each item directing staff to the applicable and specific plan sheet or document and page number.

When you receive a 2<sup>nd</sup> submittal / 1<sup>st</sup> revised submittal from the applicant, please notify me and provide PDF and print copies of the materials and specify a desired due date for Planning review comments.

Feel free to contact me at (503) 980-2485 or <colin.cortes@ci.woodburn.or.us>.

## Attachment(s):

Civil engineering plan set: (1<sup>st</sup> submittal, February 8, 2022; excerpted: Sheets UT-1 / 4, SP-1 / 25, & SP-2 / 26)

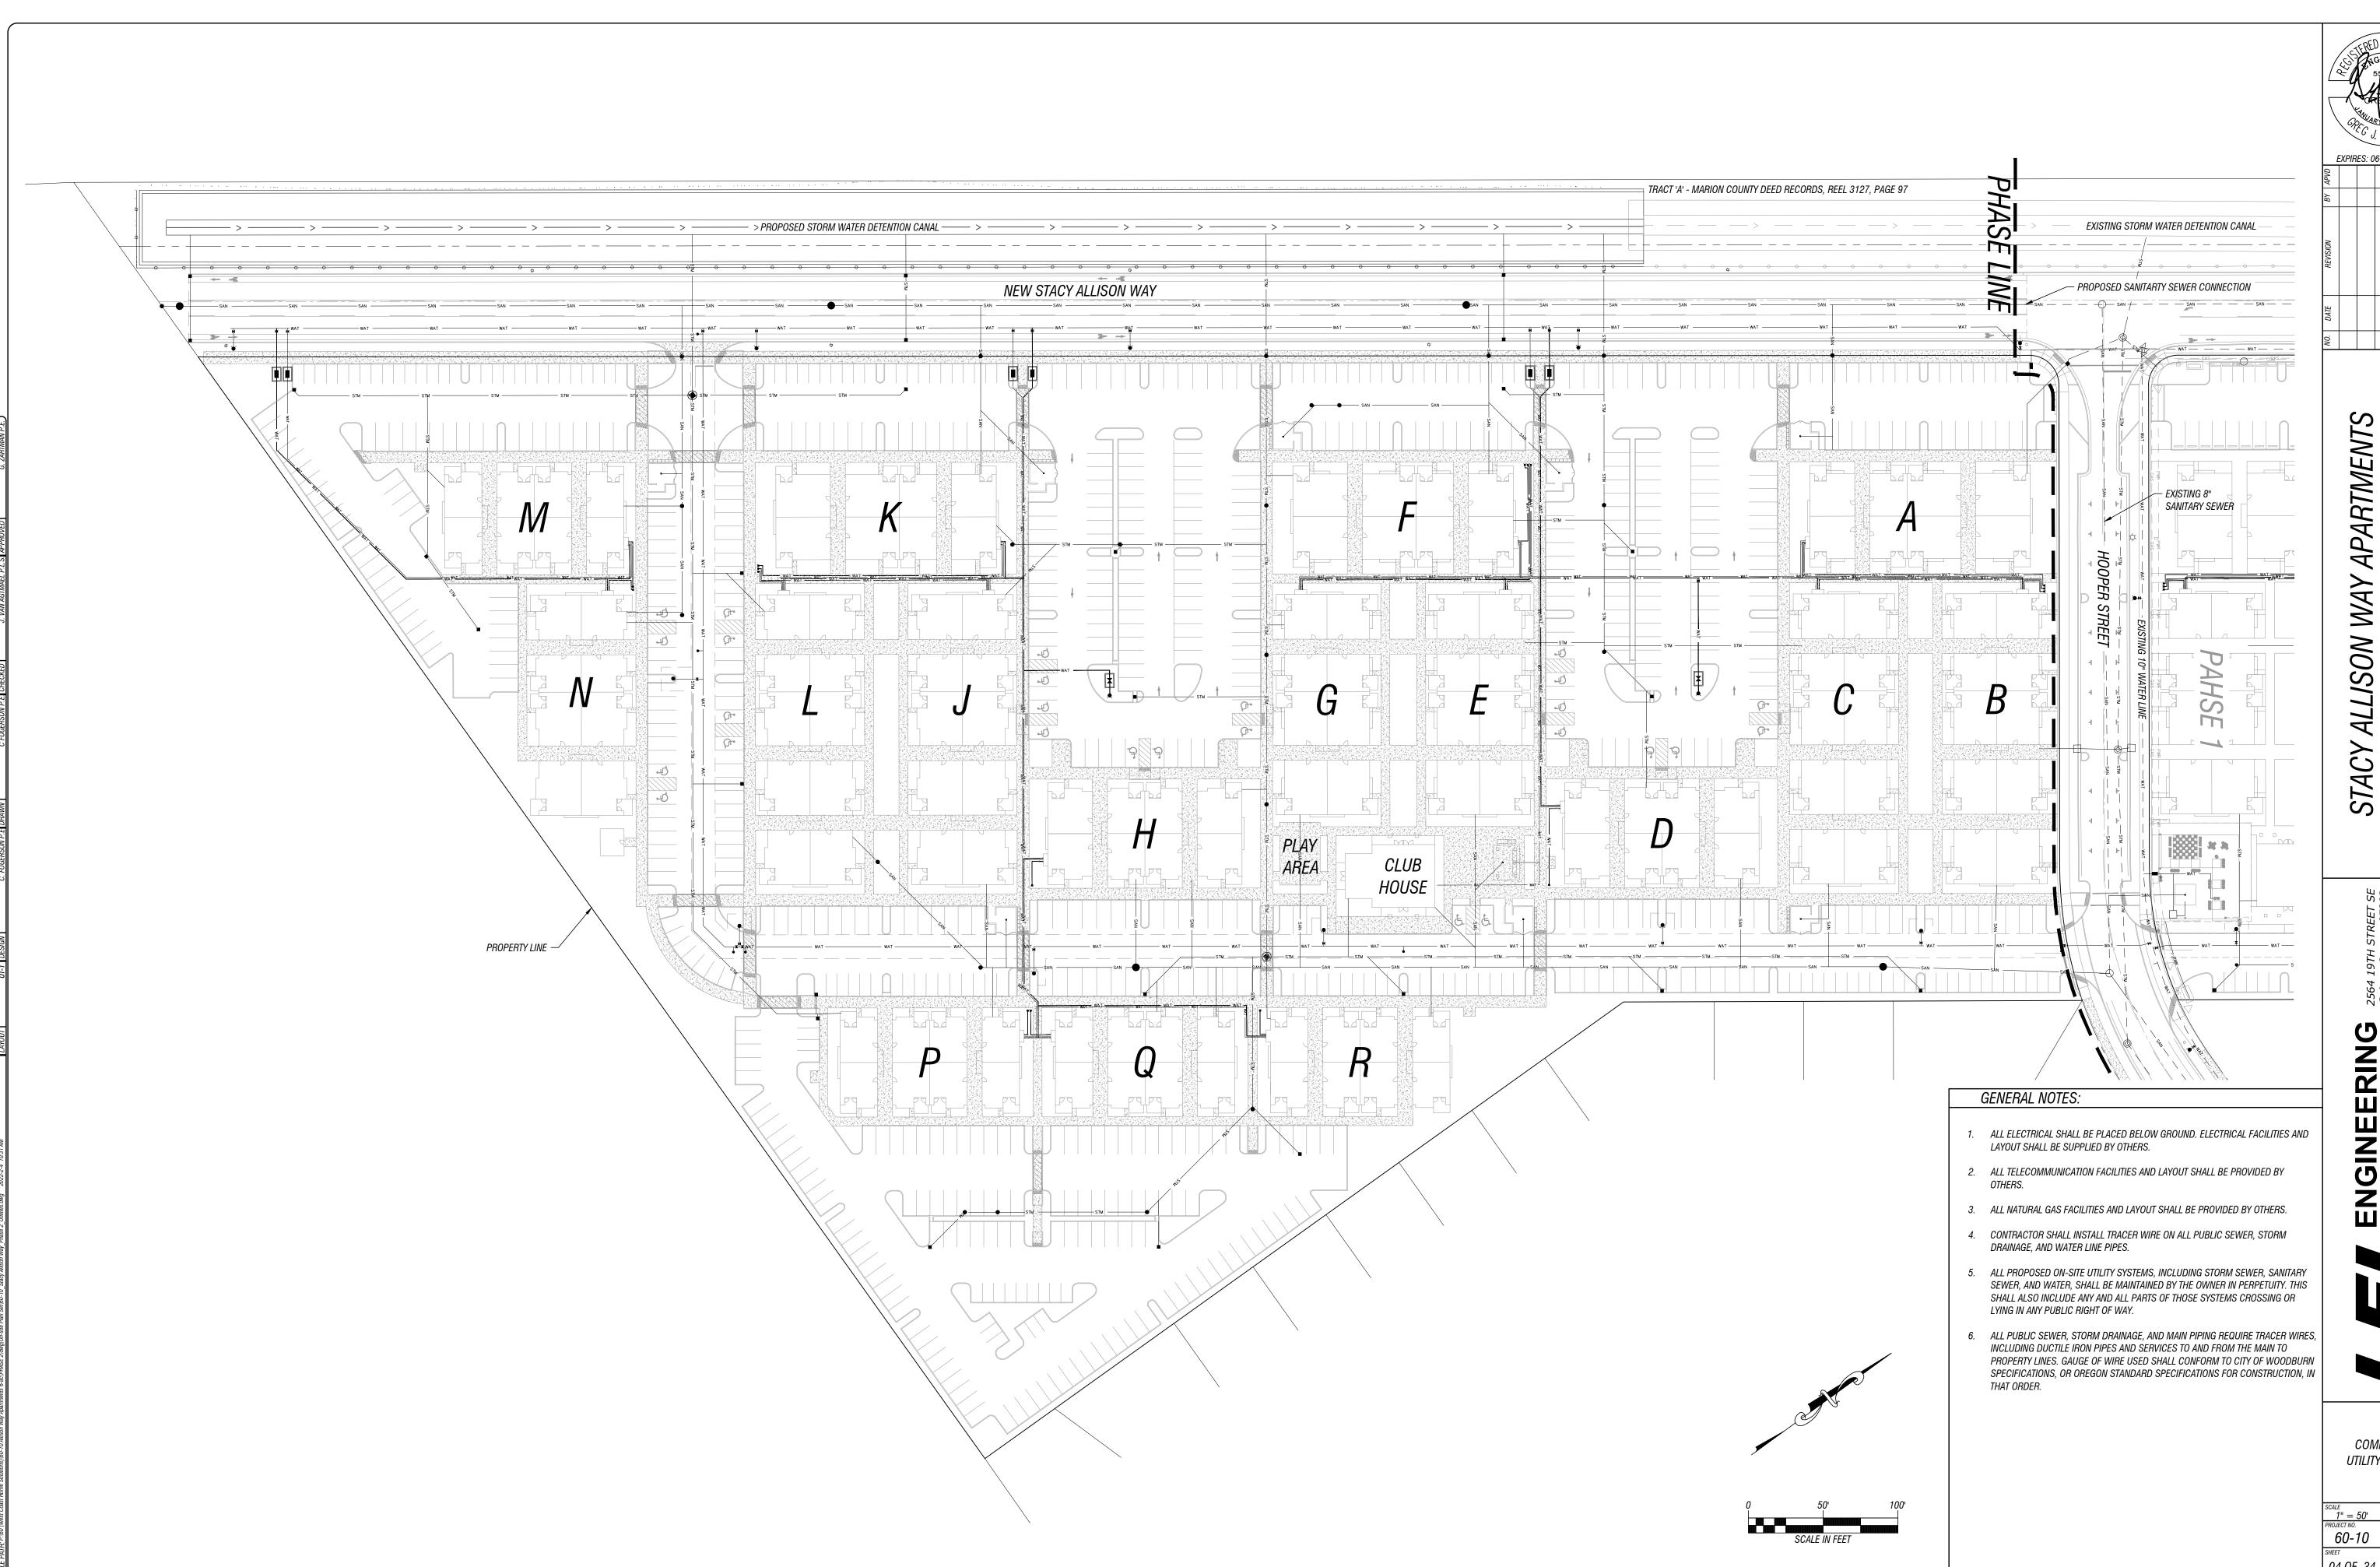


RENGINEERING

& SURVEYING

OREGON

COMPOSITE UTILITY LAYOUT

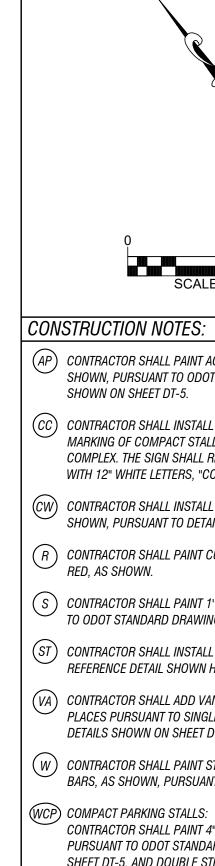

W14-2

24 .375 .625 5 D 3 .75 4.125 4.5 11.625 12.063 1.5

2-118

BACKGROUND — YELLOW (RETROREFLECTIVE)

C 30 .5 .75 6 D 4 .938 5 5.375 13.938 14.5 1.875

COLORS: LEGEND — BLACK

NO OUTLET


A B C D E F G H J K L 
 C
 24
 .375
 .625
 5 D
 1
 2
 8.25
 8.563
 5.625
 6.25
 1.5


 30
 .5
 .75
 6 D
 1.5
 2.5
 9.75
 10.25
 6.75
 7.5
 1.875

 36
 .625
 .875
 7 D
 2
 3
 11.375
 11.938
 7.875
 8.75
 2.25

> COLORS: LEGEND — BLACK BACKGROUND — YELLOW (RETROREFLECTIVE)

> > 2-116

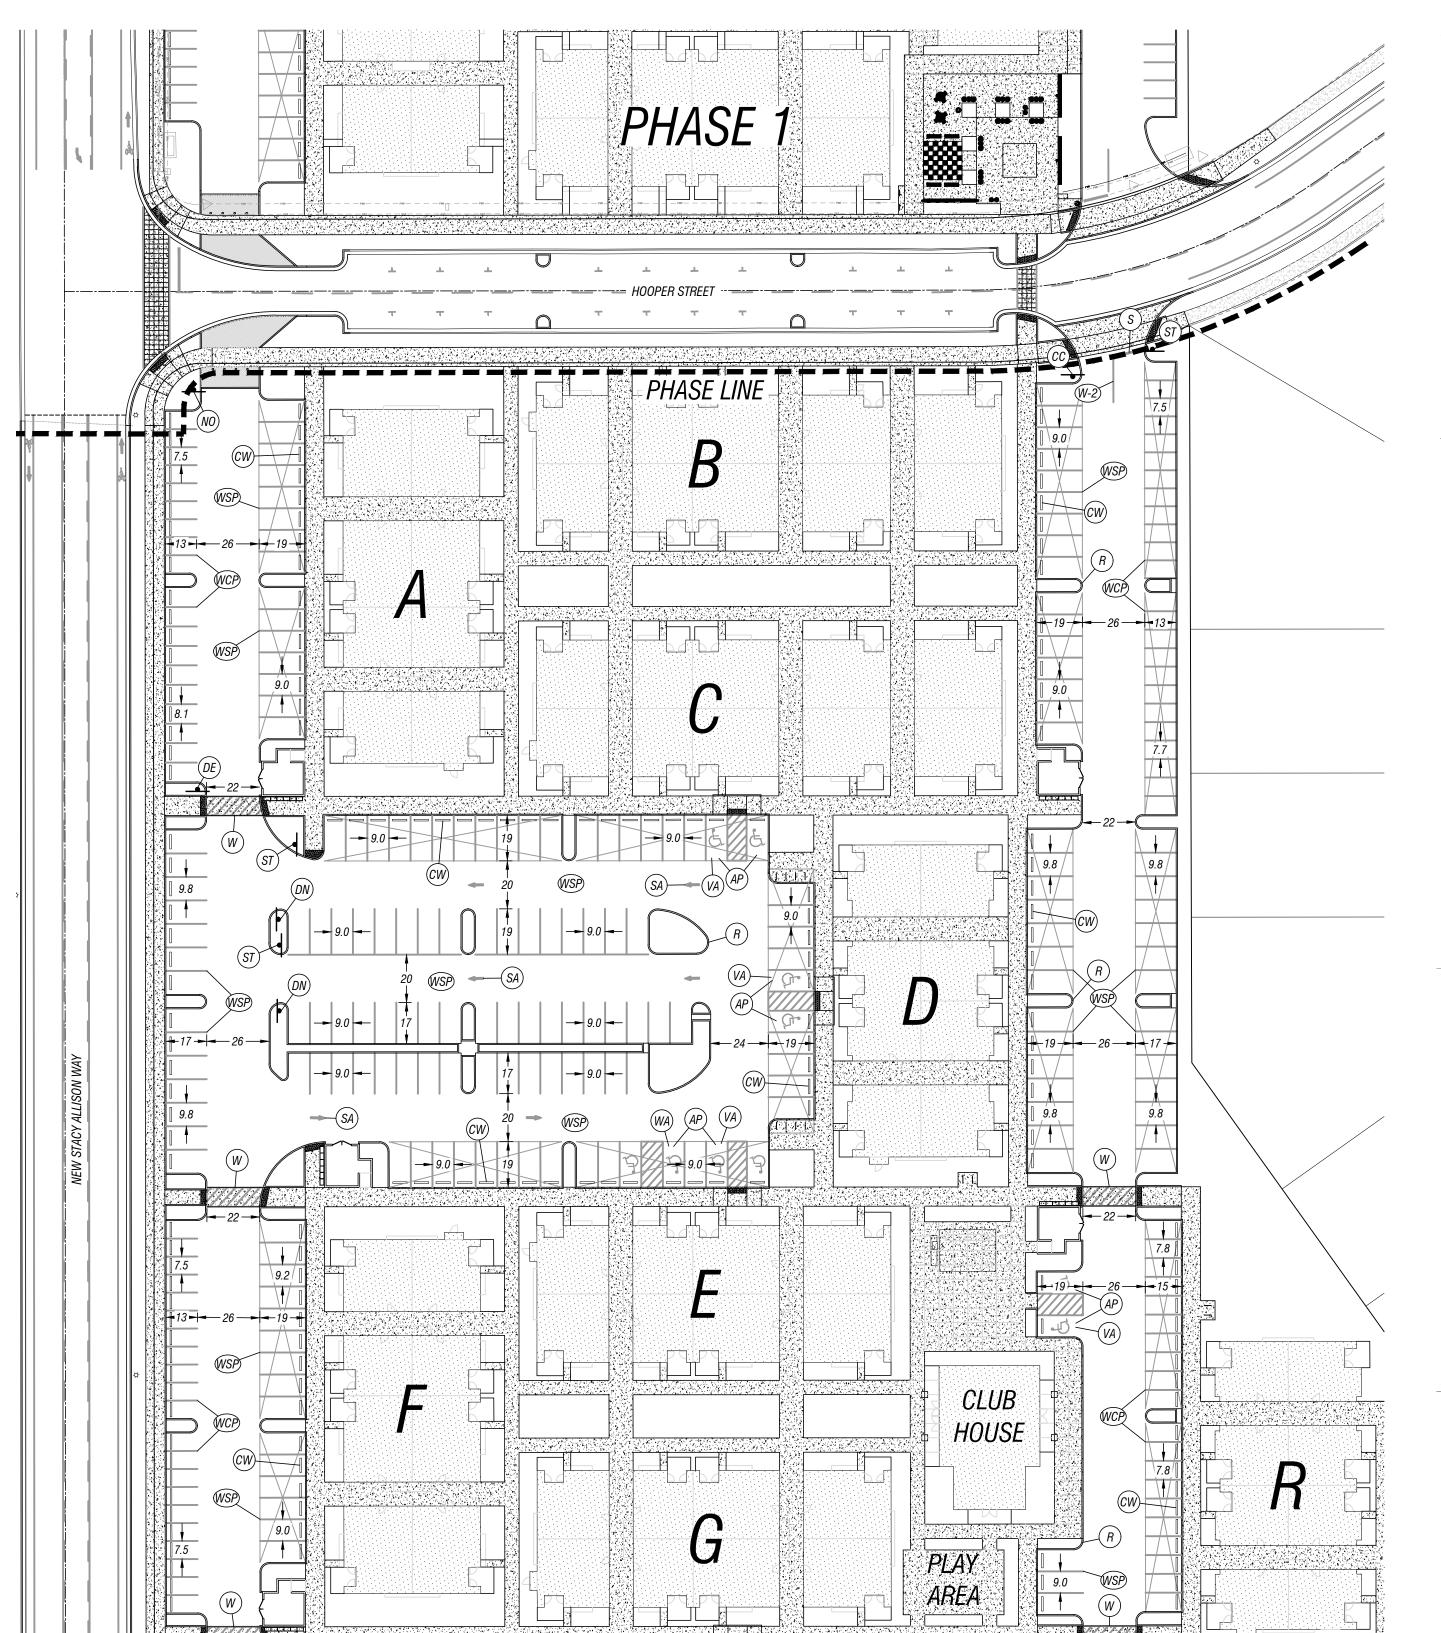

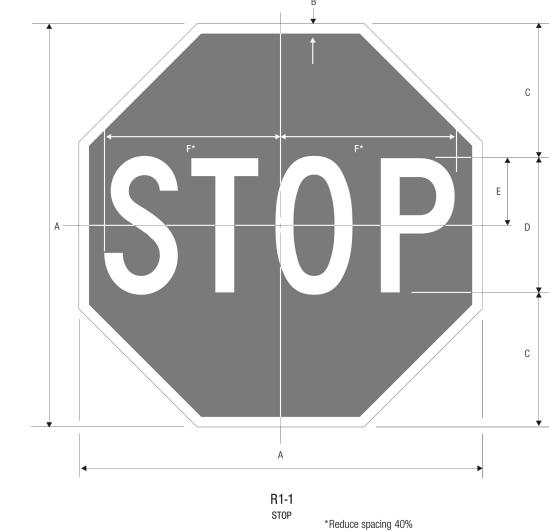

18 .375 6 6 C 3 7.75 24 .625 8 8 C 4 10 30 .75 10 10 C 5 12.5 36 .875 12 12 C 6 15 48 1.25 16 16 C 8 20

COLORS: LEGEND — WHITE (RETROREFLECTIVE) BACKGROUND — RED (RETROREFLECTIVE) 1-1

R5-1 DO NOT ENTER


> RED (RETROREFLECTIVE) COLORS: SYMBOL LEGEND & BACKGROUND - WHITE (RETROREFLECTIVE) 1-73


A B C D E F G H J K L

 36
 7.5
 5 D
 2.5
 6
 17.5
 15
 12
 12.375
 2.25
 9.813

 48
 11
 6 D
 3
 8
 23.5
 20
 14.5
 15
 3
 11.75

 C
 30
 6.5
 4 D
 2
 5
 14.5
 12.5
 9.75
 10
 1.875
 7.875

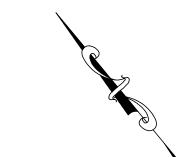

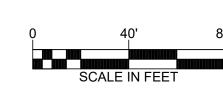

- (AP) CONTRACTOR SHALL PAINT ACCESSIBLE PARKING AREA, AS SHOWN, PURSUANT TO ODOT STANDARD DRAWING TM500
- (CC) CONTRACTOR SHALL INSTALL A CUSTOM SIGN DESCRIBING THE MARKING OF COMPACT STALLS AT THE ENTRANCE OF THE COMPLEX. THE SIGN SHALL READ, "COMPACT STALLS MARKED WITH 12" WHITE LETTERS, "COMPACT ONLY"".
- (CW) CONTRACTOR SHALL INSTALL CONCRETE WHEEL STOPS, AS SHOWN, PURSUANT TO DETAIL ON SHEET DT-4.
- R CONTRACTOR SHALL PAINT CURB IN FRONT OF FIRE ACCESS LANE
- (S) CONTRACTOR SHALL PAINT 1' STOP BAR, AS SHOWN, PURSUANT TO ODOT STANDARD DRAWING TM503 SHOWN ON SHEET DT-5.
- (ST) CONTRACTOR SHALL INSTALL R1-1 "STOP SIGN", AS SHOWN. REFERENCE DETAIL SHOWN HEREON.
- (VA) CONTRACTOR SHALL ADD VAN-ACCESSIBLE SIGNAGE TO PARKING PLACES PURSUANT TO SINGLE AND DOUBLE ACCESSIBLE PARKING DETAILS SHOWN ON SHEET DT-6.
- (W) CONTRACTOR SHALL PAINT STANDARD CROSSWALK TWO 1' WHITE BARS, AS SHOWN, PURSUANT TO DETAIL ON SHEET DT-5.
- CONTRACTOR SHALL PAINT 4" WHITE LANE STRIPING, AS SHOWN, PURSUANT TO ODOT STANDARD DRAWING TM500 SHOWN ON SHEET DT-5, AND DOUBLE STRIPED PURSUANT TO CITY OF WOODBURN DETAIL, SHOWN ON SHEET DT-5. COMPACT PARKING STALLS SHALL BE PAINTED WITH 12" WHITE LETTERS, "COMPACT
- (WSP) STANDARD PARKING STALLS: CONTRACTOR SHALL PAINT 4" WHITE LANE STRIPING, AS SHOWN, PURSUANT TO ODOT STANDARD DRAWING TM500 SHOWN ON SHEET DT-4 AND DOUBLE STRIPED PURSUANT TO CITY OF WOODBURN DETAIL. SHOWN ON SHEET DT-5.
- (W-2) CONTRACTOR SHALL PAINT 8" WHITE LANE LINE, AS SHOWN, PURSUANT TO ODOT STANDARD DRAWING TM500 SHOWN ON
- (NO) CONTRACTOR SHALL INSTALL W14-2 "NO OUTLET" SIGN, AS SHOWN. CONTRACTOR SHALL ALSO INSTALL CUSTOM ALUMINUM SIGN THAT READS "FIRE EXIT DO NOT BLOCK", OR EQUIVALENT, TO INDICATE THAT THE FIRE EXIT SHALL NOT BE BLOCKED AT ANY TIME.
- (SA) CONTRACTOR SHALL PAINT STRAIGHT ARROW FOR ONE-WAY DRIVE AISLE, AS SHOWN, PURSUANT TO ODOT STANDARD DRAWING TM501 ON SHEET DT-5.
- (DE) CONTRACTOR SHALL INSTALL W14-1 "DEAD END" SIGN, AS SHOWN. REFERENCE DETAIL SHOWN HEREON.
- (DN) CONTRACTOR SHALL INSTALL R5-1 "DO NOT ENTER" SIGN, AS SHOWN. REFERENCE DETAIL SHOWN HEREON.

# GENERAL NOTES:

REFERENCE ARCHITECTURAL AND STRUCTURAL PLANS FOR DETAILS AND SPECIFICATIONS FOR THE CONSTRUCTION OF CARPORTS ON THE

PARKING STALLS THAT OVERHANG A PLANTING AREA ARE 2' SHORTER IN

SIGNS SHALL BE MOUNTED IN THE FOLLOWING MANNER: 1: 2" - 12GA SINGLE PERFORATED STEEL SQUARE TUBE AS DESCRIBED AND SPECIFIED ON ODOT STANDARD DETAIL TM681

- SHOWN ON SHEET DT-6. 2: POST SHALL BE MOUNTED IN ANCHOR FOUNDATION DESCRIBED IN ODOT STANDARD DETAIL TM687 SHOWN ON SHEET DT-6.
- SIGNS SHALL BE MOUNTED TO POST PURSUANT TO ODOT STANDARD DETAIL TM676 SHOWN ON SHEET DT-6.

PLAN


**STRIPING** 


& SURVEYING
OREGON

COAST

SP-1 60-10



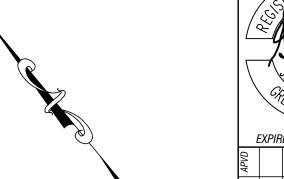

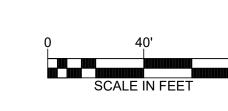

## CONSTRUCTION NOTES:

- (AP) CONTRACTOR SHALL PAINT ACCESSIBLE PARKING AREA, AS SHOWN, PURSUANT TO ODOT STANDARD DRAWING TM500 SHOWN ON SHEET DT-5.
- (CC) CONTRACTOR SHALL INSTALL A CUSTOM SIGN DESCRIBING THE MARKING OF COMPACT STALLS AT THE ENTRANCE OF THE COMPLEX. THE SIGN SHALL READ, "COMPACT STALLS MARKED WITH 12" WHITE LETTERS, "COMPACT ONLY"".
- (CW) CONTRACTOR SHALL INSTALL CONCRETE WHEEL STOPS, AS SHOWN, PURSUANT TO DETAIL ON SHEET DT-4.
- R CONTRACTOR SHALL PAINT CURB IN FRONT OF FIRE ACCESS LANE RED, AS SHOWN.
- S CONTRACTOR SHALL PAINT 1' STOP BAR, AS SHOWN, PURSUANT TO ODOT STANDARD DRAWING TM503 SHOWN ON SHEET DT-5.
- (ST) CONTRACTOR SHALL INSTALL R1-1 "STOP SIGN", AS SHOWN. REFERENCE DETAIL SHOWN ON SHEET SP-1.
- (VA) CONTRACTOR SHALL ADD VAN-ACCESSIBLE SIGNAGE TO PARKING PLACES PURSUANT TO SINGLE AND DOUBLE ACCESSIBLE PARKING DETAILS SHOWN ON SHEET DT-6.
- W CONTRACTOR SHALL PAINT STANDARD CROSSWALK TWO 1' WHITE BARS, AS SHOWN, PURSUANT TO DETAIL ON SHEET DT-5.
- WCP) COMPACT PARKING STALLS: CONTRACTOR SHALL PAINT 4" WHITE LANE STRIPING, AS SHOWN, PURSUANT TO ODOT STANDARD DRAWING TM500 SHOWN ON SHEET DT-5, AND DOUBLE STRIPED PURSUANT TO CITY OF WOODBURN DETAIL, SHOWN ON SHEET DT-5. COMPACT PARKING STALLS SHALL BE PAINTED WITH 12" WHITE LETTERS, "COMPACT
- WSP) STANDARD PARKING STALLS: CONTRACTOR SHALL PAINT 4" WHITE LANE STRIPING, AS SHOWN, PURSUANT TO ODOT STANDARD DRAWING TM500 SHOWN ON SHEET DT-5 AND DOUBLE STRIPED PURSUANT TO CITY OF WOODBURN DETAIL, SHOWN ON SHEET DT-5.
- (W-2) CONTRACTOR SHALL PAINT 8" WHITE LANE LINE, AS SHOWN, PURSUANT TO ODOT STANDARD DRAWING TM500 SHOWN ON
- (NO) CONTRACTOR SHALL INSTALL W14-2 "NO OUTLET" SIGN, AS SHOWN. CONTRACTOR SHALL ALSO INSTALL CUSTOM ALUMINUM SIGN THAT READS "FIRE EXIT DO NOT BLOCK", OR EQUIVALENT, TO INDICATE THAT THE FIRE EXIT SHALL NOT BE BLOCKED AT ANY TIME.
- (SA) CONTRACTOR SHALL PAINT STRAIGHT ARROW FOR ONE-WAY DRIVE AISLE, AS SHOWN, PURSUANT TO ODOT STANDARD DRAWING TM501 ON SHEET DT-5.
- (DE) CONTRACTOR SHALL INSTALL W14-1 "DEAD END" SIGN, AS SHOWN. REFERENCE DETAIL SHOWN ON SHEET SP-1.
- (DN) CONTRACTOR SHALL INSTALL R5-1 "DO NOT ENTER" SIGN, AS SHOWN. REFERENCE DETAIL SHOWN ON SHEET SP-1.

# GENERAL NOTES:

REFERENCE ARCHITECTURAL AND STRUCTURAL PLANS FOR DETAILS AND SPECIFICATIONS FOR THE CONSTRUCTION OF CARPORTS ON THE

PARKING STALLS THAT OVERHANG A PLANTING AREA ARE 2' SHORTER IN

SIGNS SHALL BE MOUNTED IN THE FOLLOWING MANNER: 1: 2" - 12GA SINGLE PERFORATED STEEL SQUARE TUBE AS DESCRIBED AND SPECIFIED ON ODOT STANDARD DETAIL TM681

- SHOWN ON SHEET DT-6. 2: POST SHALL BE MOUNTED IN ANCHOR FOUNDATION DESCRIBED IN ODOT STANDARD DETAIL TM687 SHOWN ON SHEET DT-6.
- SIGNS SHALL BE MOUNTED TO POST PURSUANT TO ODOT STANDARD DETAIL TM676 SHOWN ON SHEET DT-6.

ENGINEERING

& SURVEYING

OREGON

STRIPING PLAN

SP-2 60-10